

**SCDHEC OFFICE OF OCEAN AND COASTAL RESOURCE MANAGEMENT  
PERMIT APPLICATION PUBLIC NOTICE**

**March 31, 2006**

**Permit Number:**

**OCRM-06-091-R**

**Permit ID:**

**54458**

The SCDHEC Office of Ocean and Coastal Resource Management has received an application for a permit for the alteration of a critical area. This application was submitted pursuant to the Coastal Zone Management Act (Act 123) of the 1977 South Carolina General Assembly. The application, in brief, is described as follows:

**APPLICANT:** Michael E. Ryan  
2244 Hartsfords Bluff Circle  
Mount Pleasant, SC 29466

**LOCATION:** On and adjacent to Wando River at 2244 Hartsfords Bluff Circle, Rivertown, Mount Pleasant, Charleston County, South Carolina.  
TMS#: 583-01-00-012.

**WORK:** The work as proposed and shown on the attached drawings consists of adding a floating jet dock to an existing structure. The applicant seeks to add an 11.5' x 17' floating jet dock landward of the existing 10' x 40' floating dock. The work as described is for the applicant's private, recreational use.

**NOTE:** The proposed floating jet dock was previously in place without OCRM authorization & has currently been removed.

This public notice is being distributed to all known interested persons and agencies to assist in developing facts on which a decision by OCRM can be based. Comments concerning the proposed work should be submitted in writing, setting forth sufficient detail to furnish a clear understanding of the reasons for support or opposition.

The decision to issue or deny a permit will be based on the individual merits of the application, the policies specified in the South Carolina Coastal Zone Management Act, and the considerations outlined in the State of South Carolina Coastal Zone Management Program. Interested parties who wish to be notified of final permit action must notify OCRM in writing of this request.

*To assure review by OCRM, comments regarding this application must be received by OCRM on or before April 15, 2006. For further information please contact the project manager for this activity, Tess Rodgers at 843-747-4323 ext. 116.*

**PLEASE REPLY TO:**


SCDHEC OFFICE OF OCEAN AND COASTAL RESOURCE MANAGEMENT  
1362 McMillan Avenue, Suite 400  
Charleston, South Carolina 29405

**Please refer to P/N# OCRM-06-091-R**

  
Tess Rodgers, Regulatory Coordinator

m

**WANDO  
RIVER**  
2200' WIDE  
© THIS POINT

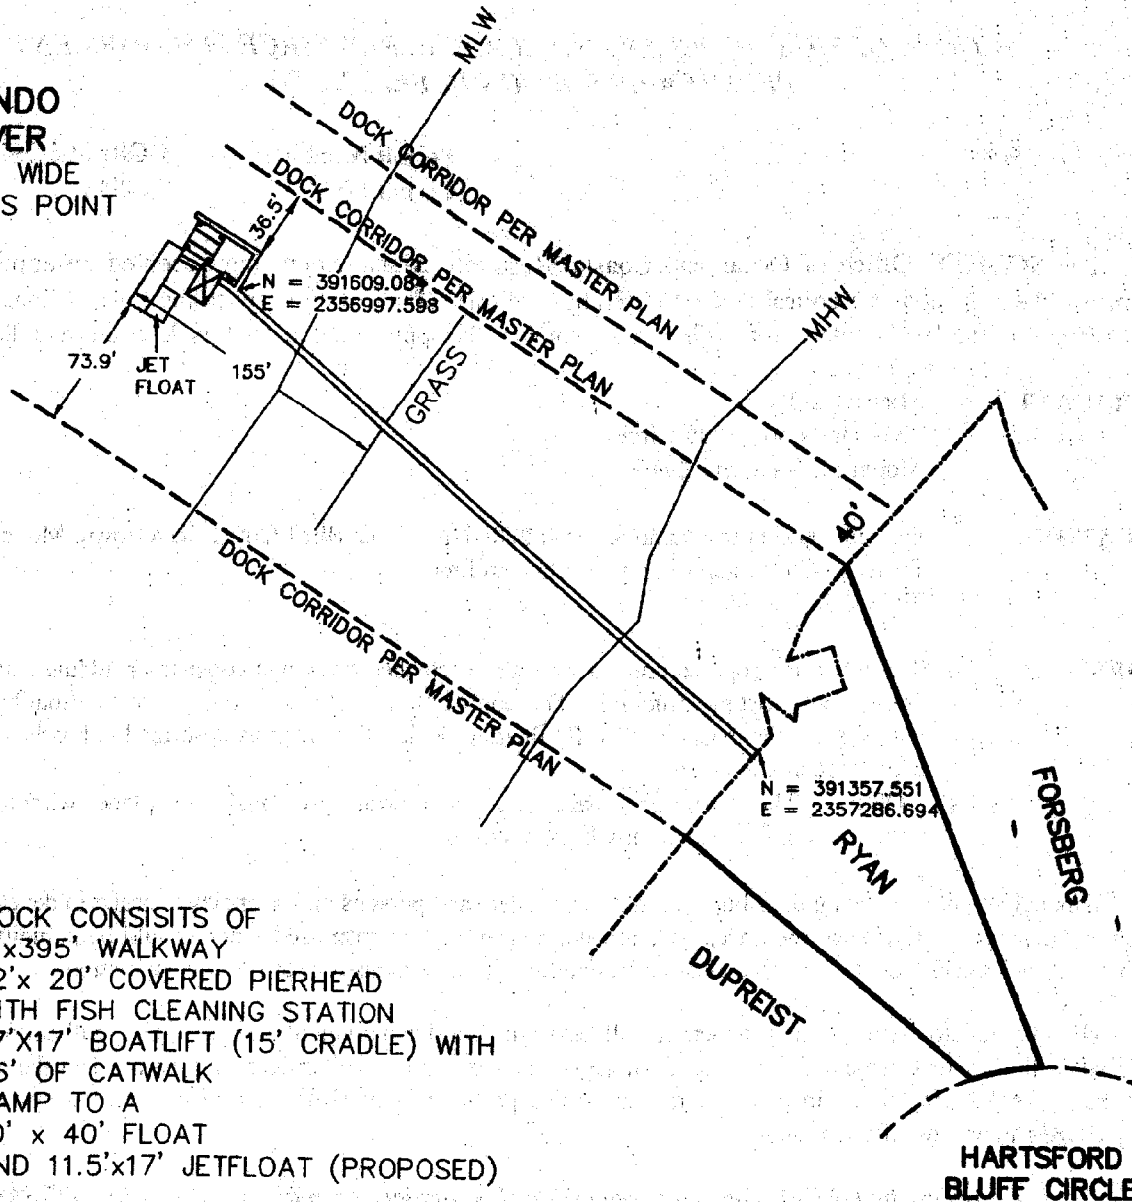

DOCK CONSISTS OF  
4'x395' WALKWAY  
12'x 20' COVERED PIERHEAD  
WITH FISH CLEANING STATION  
17'x17' BOATLIFT (15' CRADLE) WITH  
66' OF CATWALK  
RAMP TO A  
10' x 40' FLOAT  
AND 11.5'x17' JETFLOAT (PROPOSED)

OCRM-06-091-12


PERMITEE: MIKE RYAN  
2244 HARTSFORDS BLUFF CIRCLE  
MT PLEASANT  
CHARLESTON COUNTY  
TMS# 583-01-00-012  
WANDO RIVER

ASBUILT  
OCRM 00-273-R


DATE: MARCH 13, 2006  
SCALE: 1" = 100'



100 0 100

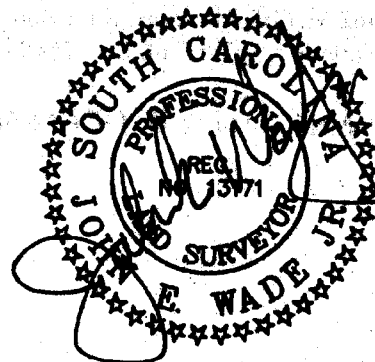

FILE #268-03

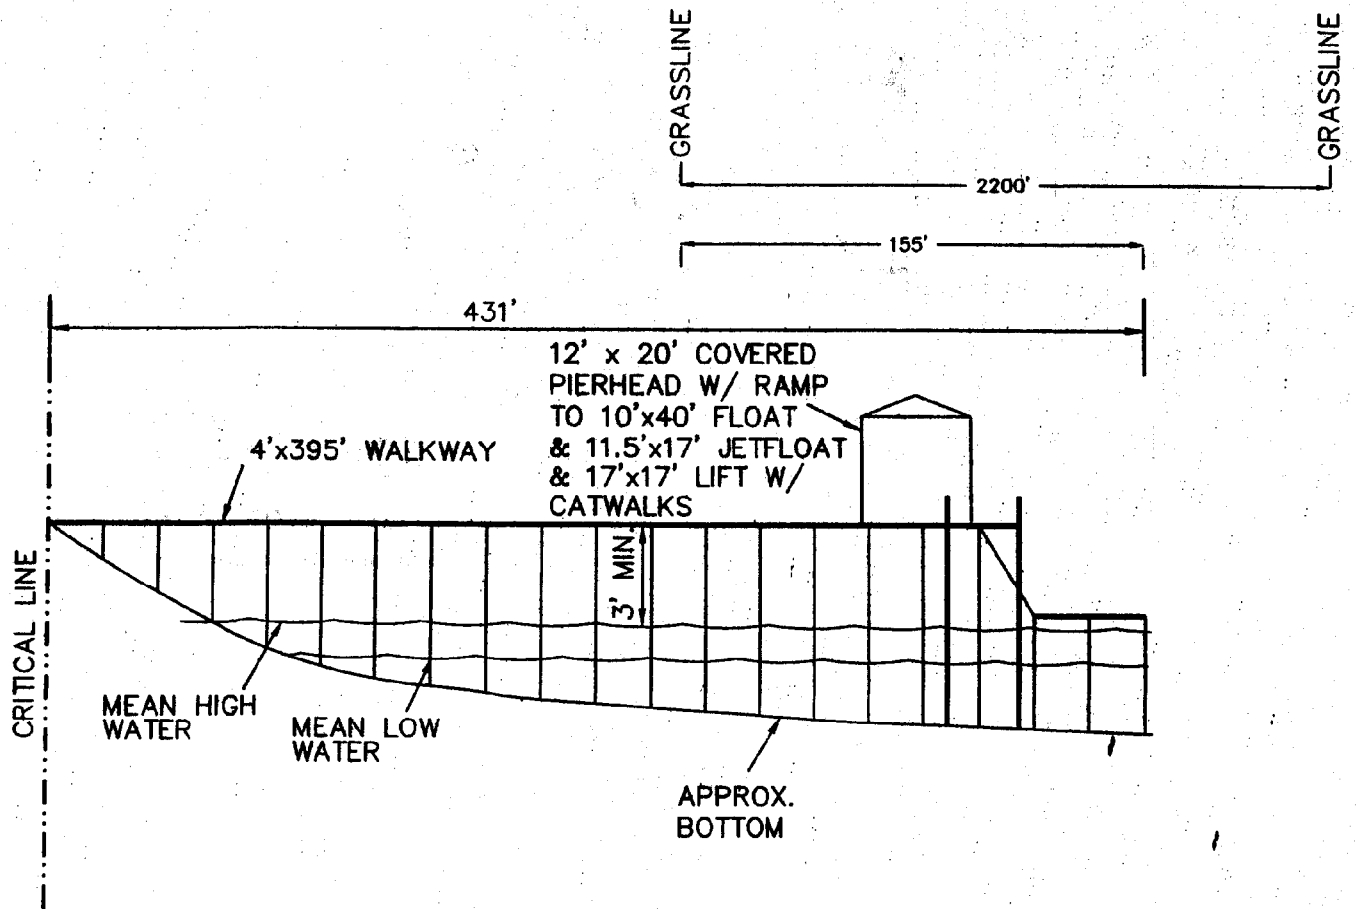

OCRM-06-091-R


PERMITEE: MIKE RYAN  
2244 HARTSFORDS BLUFF CIRCLE  
MT PLEASANT  
CHARLESTON COUNTY  
TMS# 583-01-00-012  
WANDO RIVER

ASBUILT  
OCRM 00-273-R


DATE: MARCH 13, 2006

NO SCALE

FILE #268-03

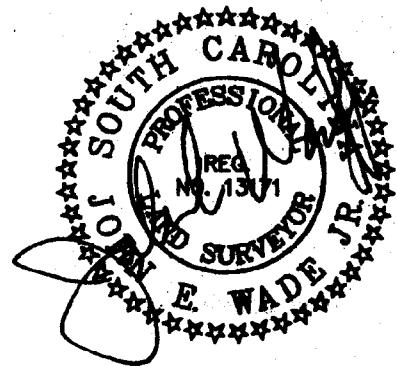

Google  
Local

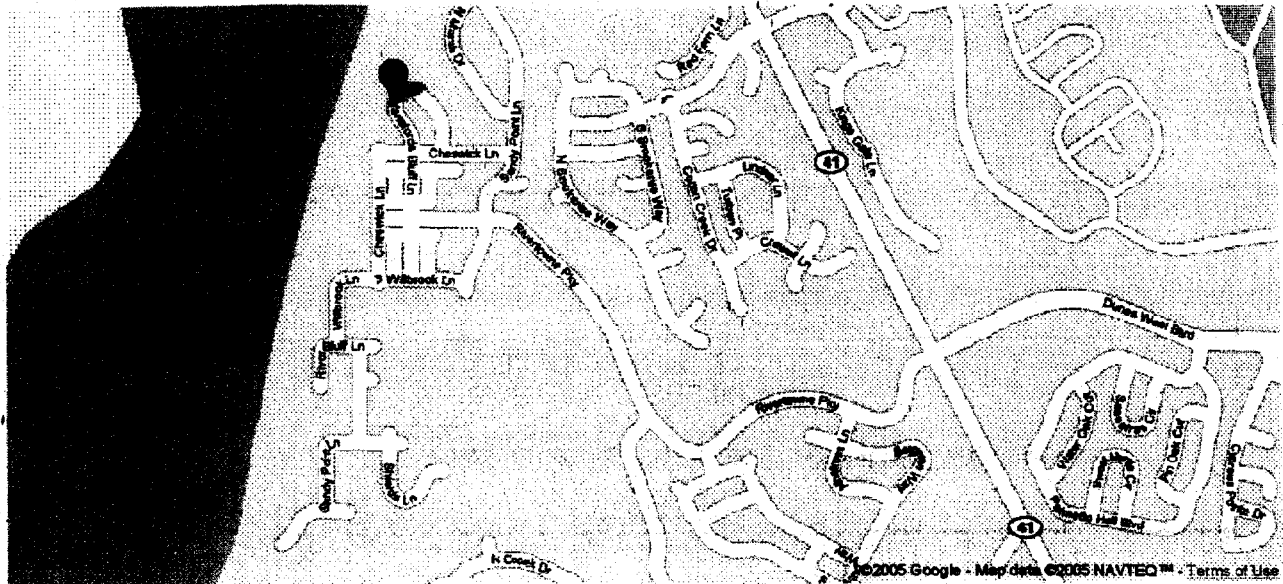

↑  
N

mike Ryan  
OCRM-06-091-R  
2244 HARTFORDSBLUFF CIRCLE  
Rivertown

<http://maps.google.com/>

3/17/2006